
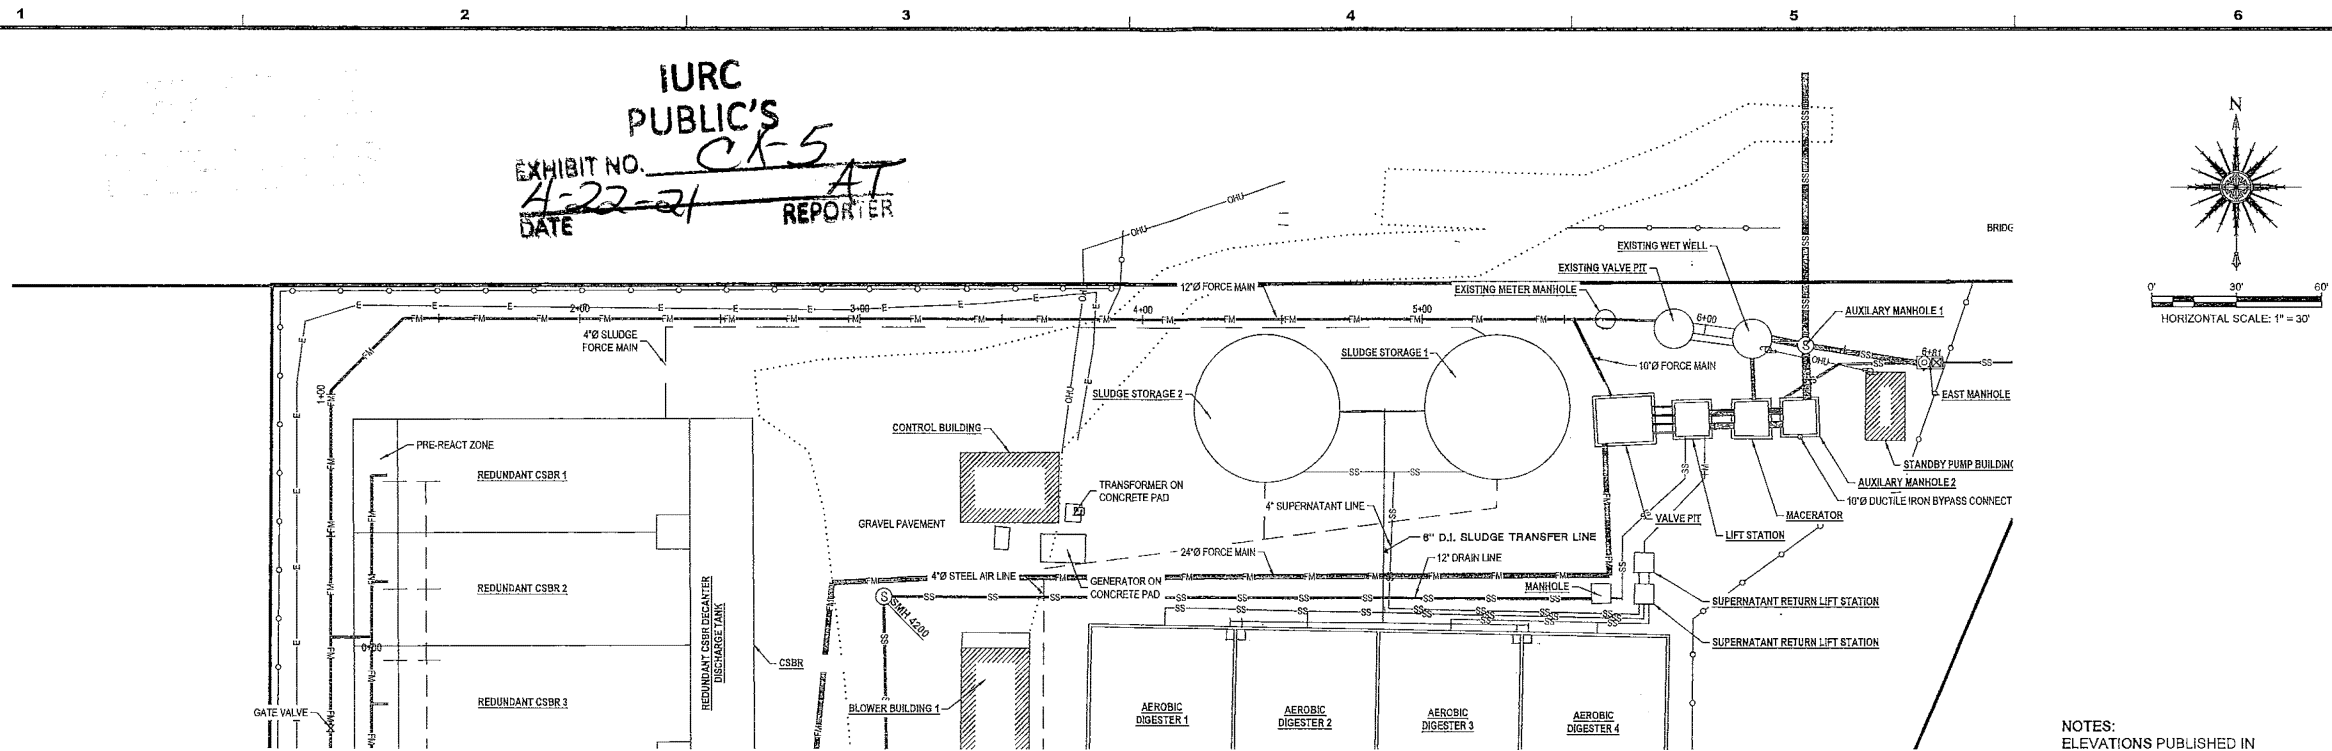


NOTES:
 ELEVATIONS PUBLISHED IN
 BRACKETS [XXX.XX] INDICATES
 ELEVATIONS PUBLISHED BY THE ENGINEER

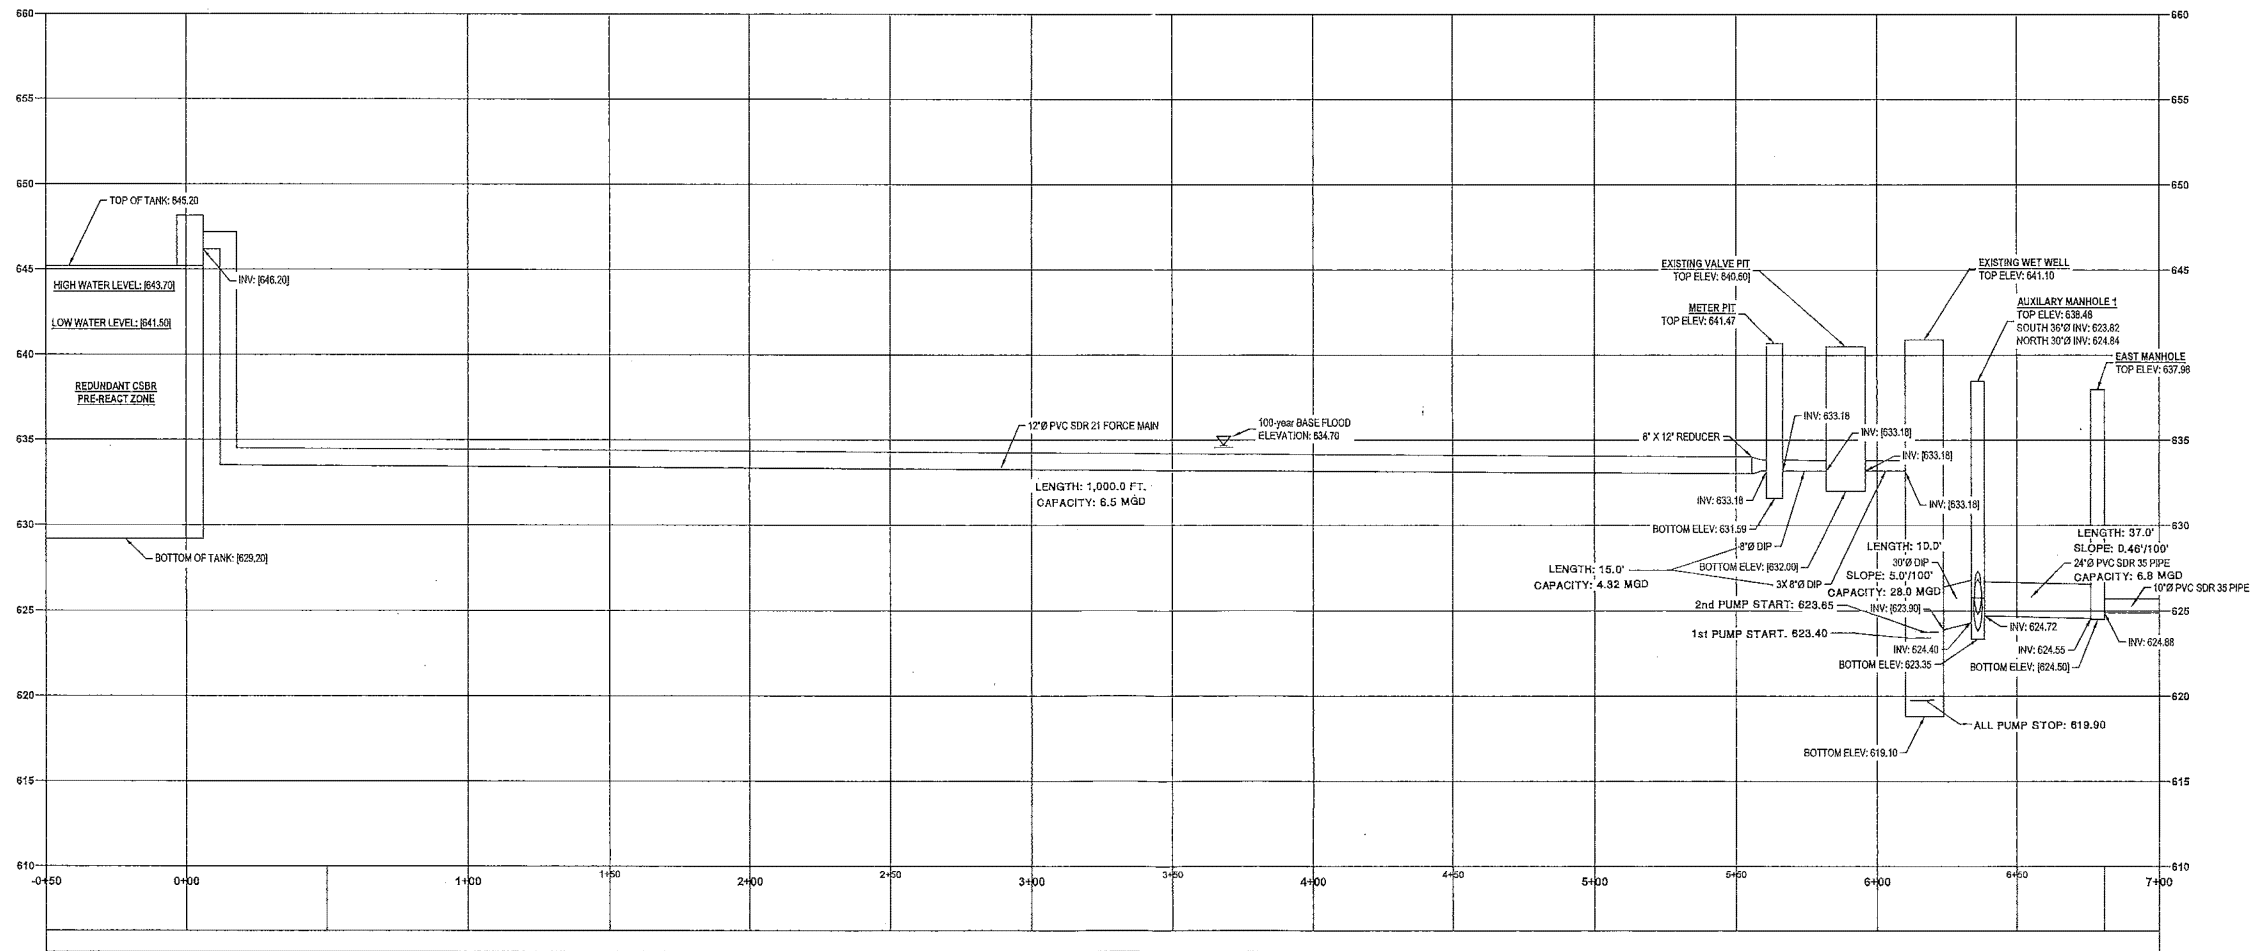

12 IN FORCE MAIN
 HORIZONTAL SCALE: 1" = 30'
 VERTICAL SCALE: 1" = 5'

AMERICAN SUBURBAN UTILITIES
 BRIDGEWAY DRIVE
 WEST LAFAYETTE, IN



CERTIFIED BY:

09/21/2020


DATE	DESCRIPTION
11/12/20	ADDED HEADWORKS WATER ELEVATIONS, PIPE LENGTHS, SLOPES AND CAPACITIES

PROJECT NO: **20015**
 FILE: 20015-AS-BULTS REV.DWG
 DRAWN BY: JSH
 CHECKED BY: PEW
 LOCATION: A PART OF THE NORTHEAST QUARTER OF SECTION 18, TOWNSHIP 23 NORTH, RANGE 5 WEST, WABASH TOWNSHIP, TIPPECANOE COUNTY, INDIANA
 TITLE: **EXISTING 12" FORCE MAIN AS-BULTS**
 PLAN SHEET: 20-005-04

FILE: P20020015 AS-B - Campus Edition AS-BULTS REV.DWG - USER: PATRICK WILLIAMS - DATE: Thursday, September 17, 2020 12:04:02 PM

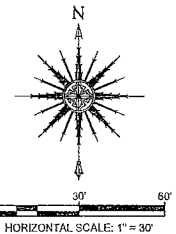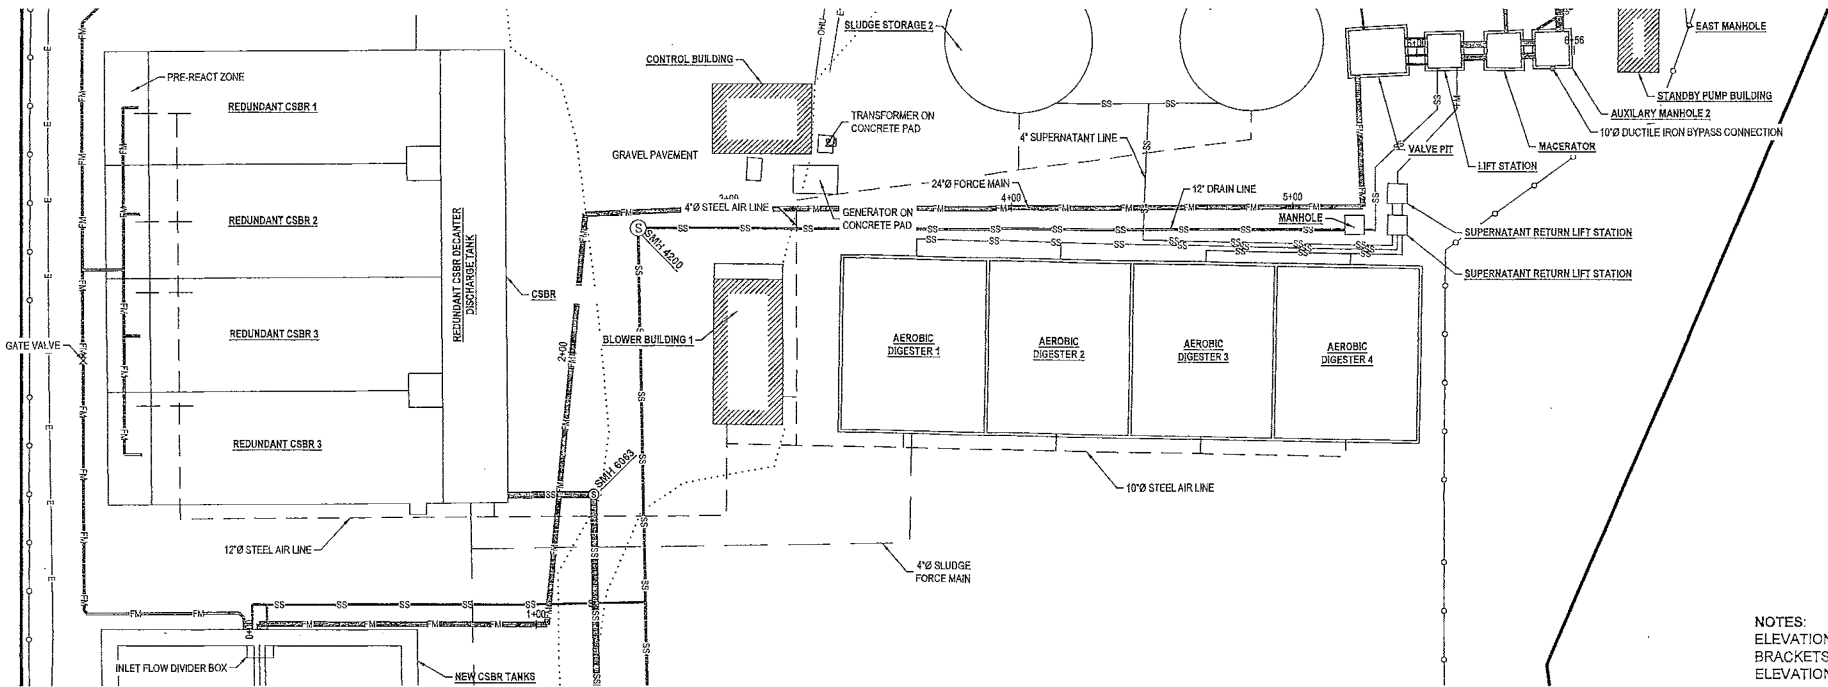

NOTES:
ELEVATIONS PUBLISHED IN
BRACKETS (XXX.XX) INDICATES
ELEVATIONS PUBLISHED BY THE ENGINEER

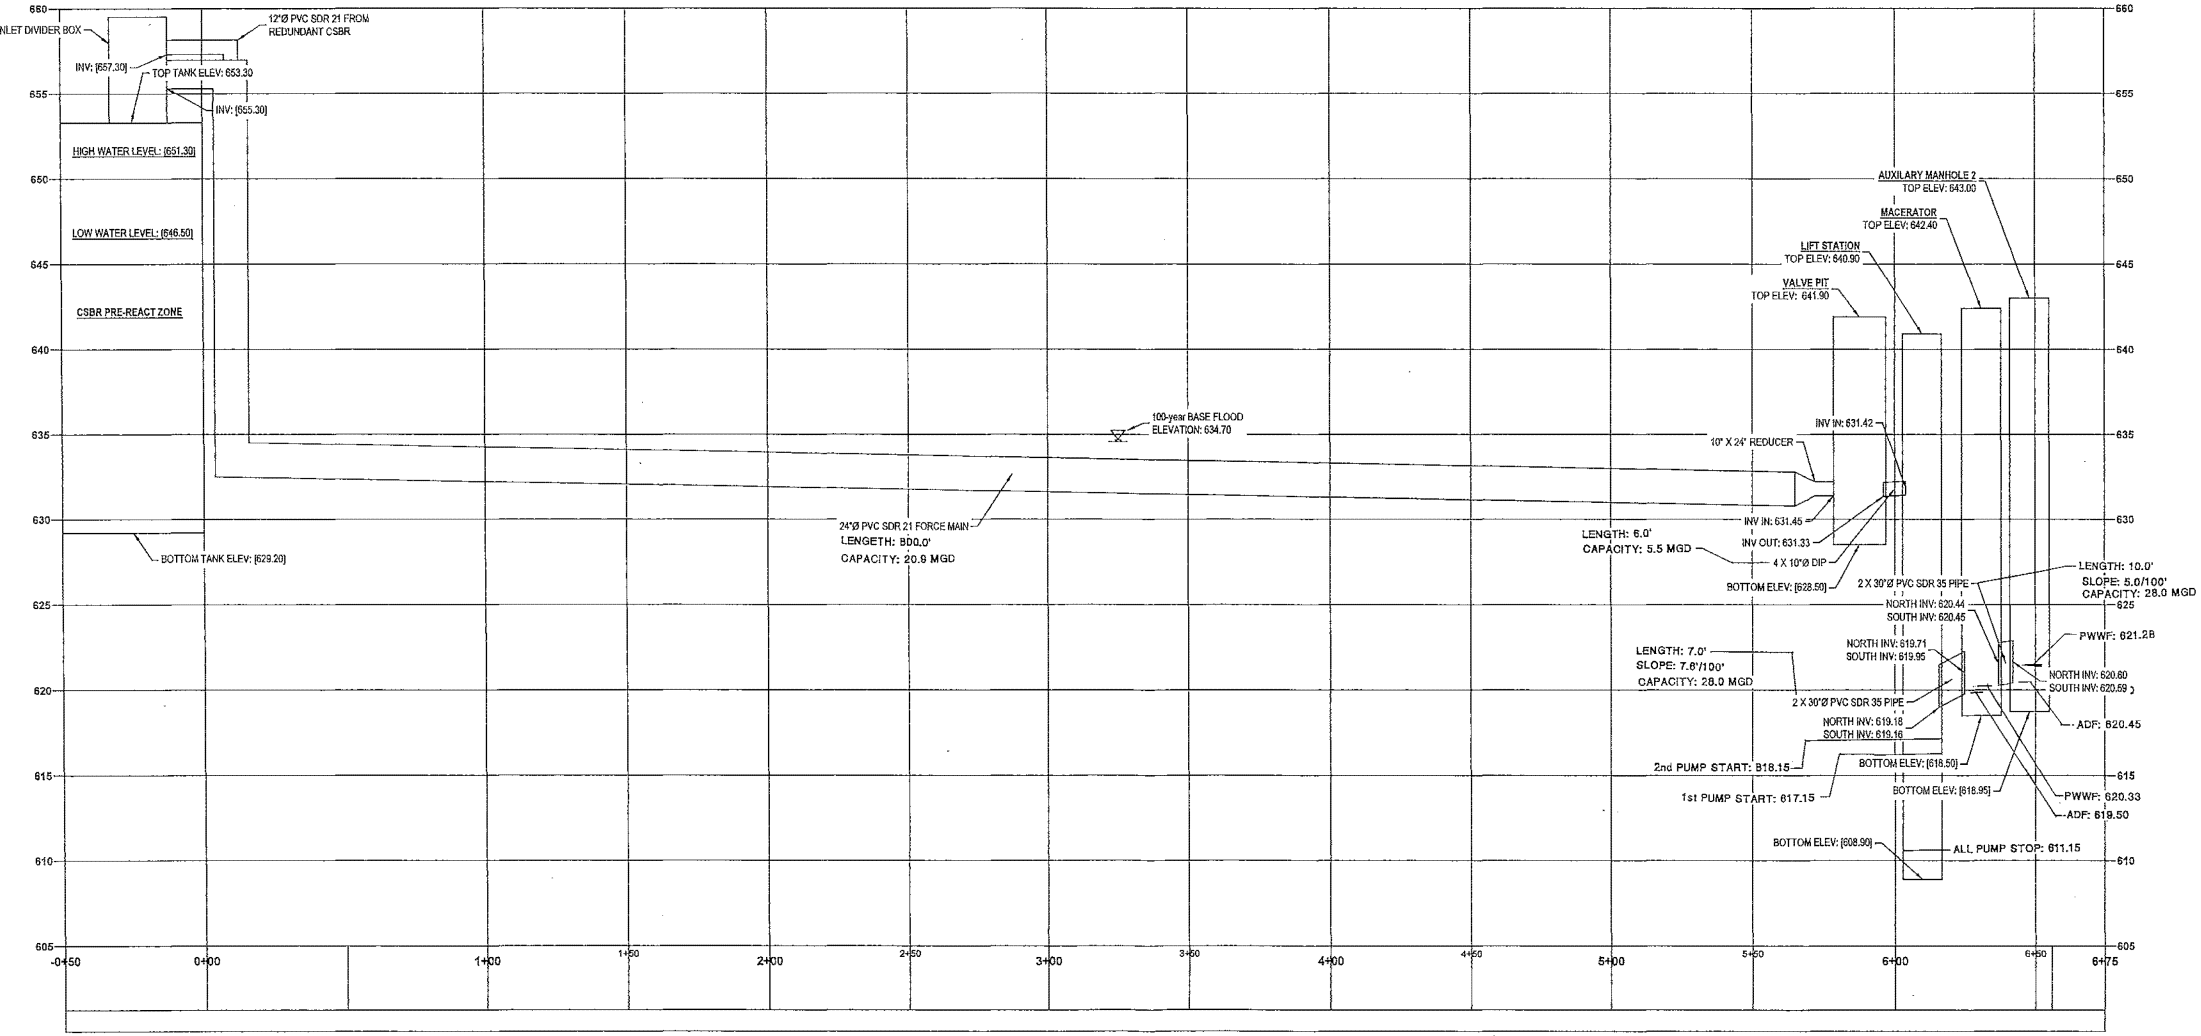

24 IN FORCE MAIN

HORIZONTAL SCALE: 1" = 30'
VERTICAL SCALE: 1" = 5'



CERTIFIED BY:
PATRICK E. WILLIAMS
REGISTERED
NO. 20800122
STATE OF INDIANA
LAND SURVEYOR
P. Williams

AMERICAN SUBURBAN UTILITIES
BRIDGEWAY DRIVE
WEST LAFAYETTE, IN

MARK	DATE	DESCRIPTION
1	11/02/20	ADDED HEADWORKS WATER ELEVATIONS, LENGTHS, SLOPES AND CAPACITIES



PROJECT NO: 20015
FILE: 20015-ASBUILTS REV.DWG
DRAWN BY: JSH
CHECKED BY: PEW
LOCATION: A PART OF THE NORTHEAST QUARTER OF SECTION 9, TOWNSHIP 23 NORTH, RANGE 5 WEST, WABASH TOWNSHIP, TIPPECANOE COUNTY, INDIANA

TITLE: **NEW 24" FORCE MAIN**
AS-BUILTS


PLAN SHEET: 20-005-05

FILE: P:\2020\2015 ASB - Canby\Estimate\ASBUILTS\20015-ASBUILTS REV.DWG - USER: PATRICK WILLIAMS - DATE: Thursday, September 17, 2020 12:18:47 PM

FILE: \\P032000015\AS-BUILT\20015-AS-BUILT\20015-AS-BUILT.dwg - USER: PATRICK WILLIAMS - DATE: Thursday, September 17, 2020 12:18:38 PM

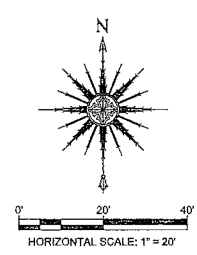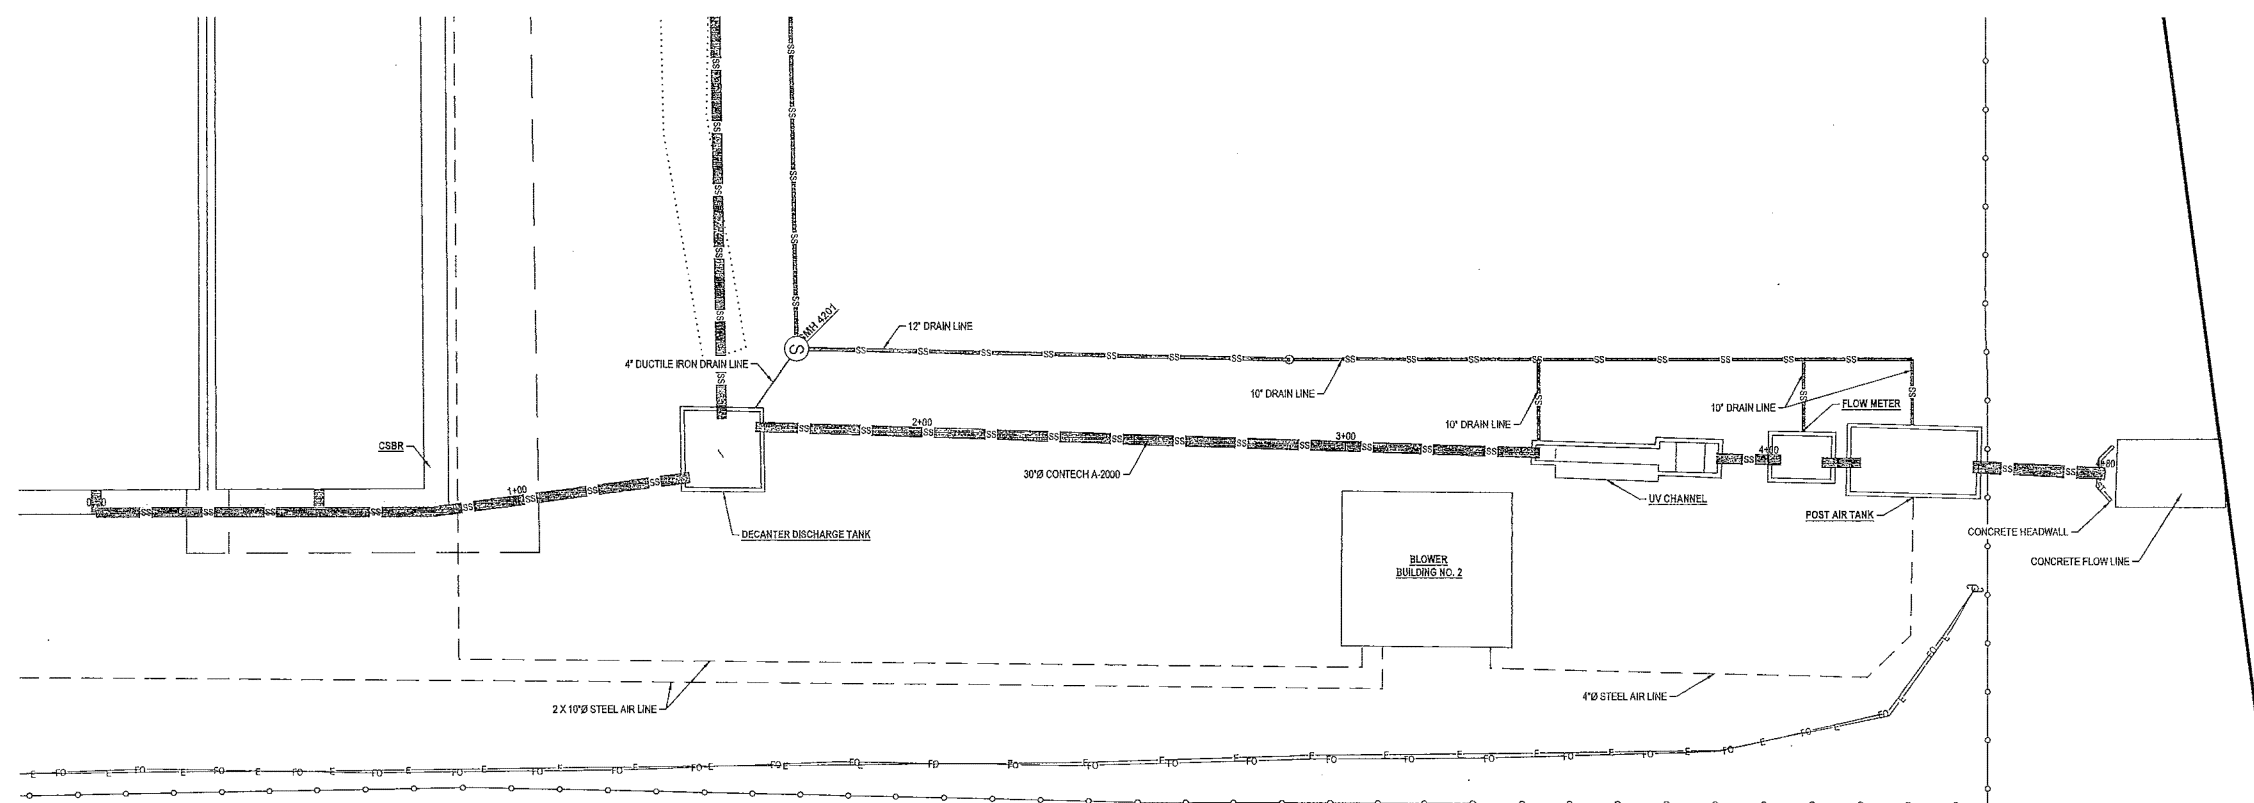

NOTES:
ELEVATIONS PUBLISHED IN
BRACKETS [XXX.XX] INDICATES
ELEVATIONS PUBLISHED BY THE ENGINEER

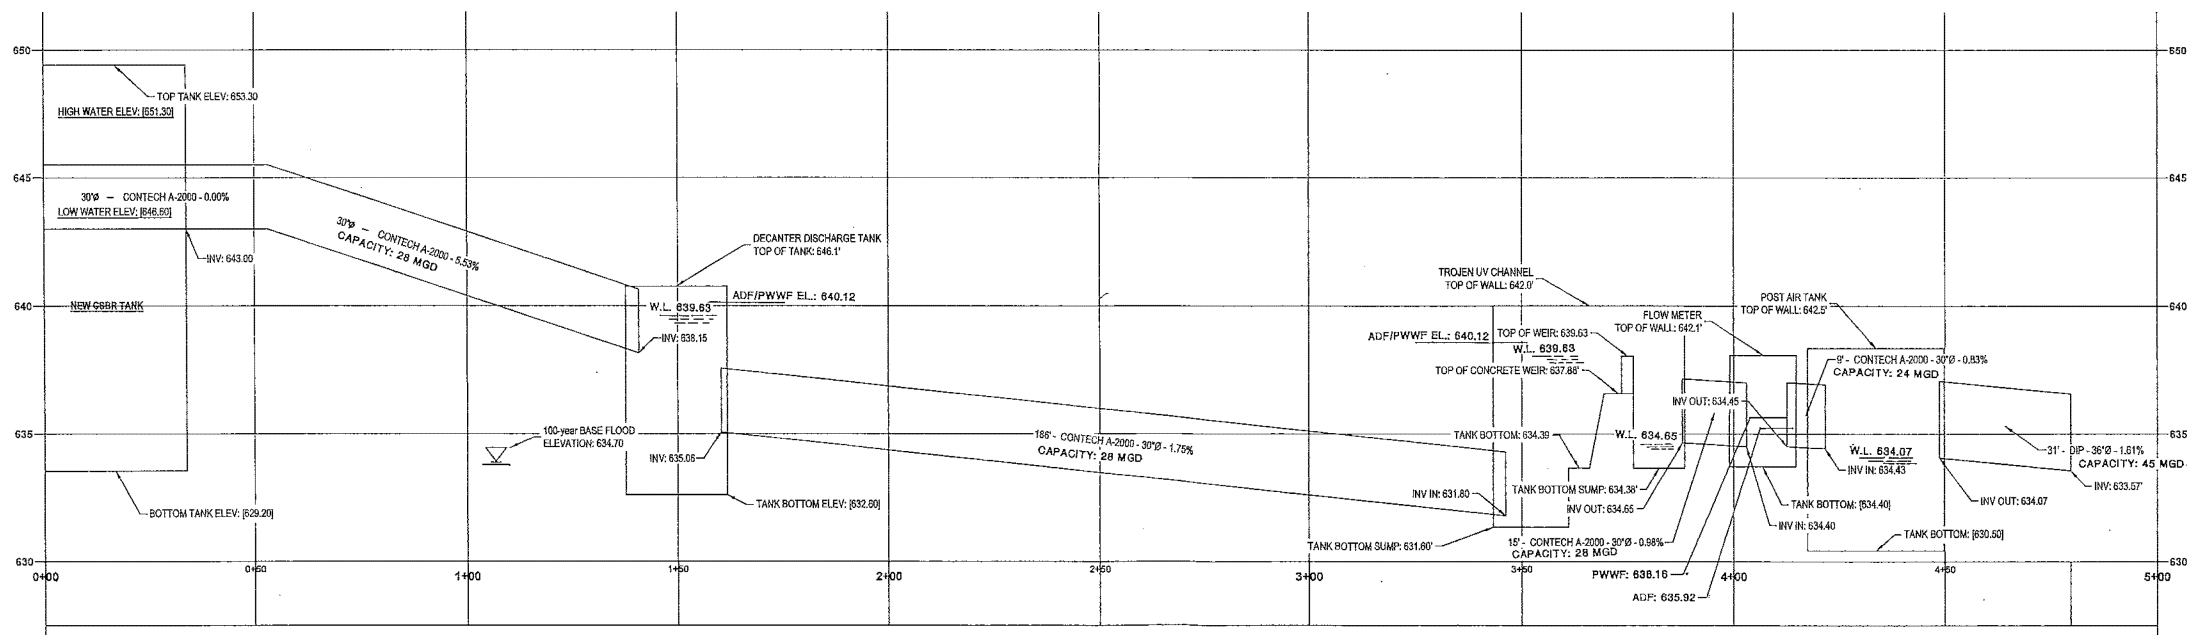

EFFLUENT LINE

0' 20' 40'

HORIZONTAL SCALE: 1" = 20'

VERTICAL SCALE: 1" = 3'

DESIGN SERVICES CORPORATION
Engineering • Surveying
Environmental • Construction Management
103 North 10th Street • Lafayette, Indiana
Phone: (765) 742-1800 • Fax: (765) 742-1805
www.asubuilt.com

CERTIFIED BY:

09/21/2020

AMERICAN SUBURBAN UTILITIES
BRIDGEWAY DRIVE
WEST LAFAYETTE, IN

MARK	DATE	DESCRIPTION
1	11/2/20	ADDED WATER LEVEL ELEVATIONS/CAPACITIES

PROJECT NO: 20015
FILE: 20015-AS-BUILT REV.DWG
DRAWN BY: JSH
CHECKED BY: PEW
LOCATION:
A PART OF THE NORTHEAST QUARTER
OF SECTION 9, TOWNSHIP 23 NORTH,
RANGE 5 WEST, WABASH TOWNSHIP,
TIPPECANOE COUNTY, INDIANA

TITLE:
EFFLUENT LINE
AS-BUILT

PLAN SHEET:
20-005-06